

JE Bowen Construction, LLC

P.O. Box Mesa, AZ. 85216-3696

Phone: (480) 393-3443 Fax: (480) 275-5083

Request for Information

TO	Robin Berry – Donna Horn
JOB NAME	CP0096 Mesa Burn Facility Expansion
DELIVERY	FTP Site Upload
RFI #	14REV -1
FROM	JE Bowen Construction
DATE	06-21-2016

Request: Plan page S-3 columns lines C-5 D-5 D-6

Please provide beam to columns details at these three locations where the beam and columns intersect.

REVISED We are requesting that you revise this detail to confirm with how we are going to pour the concrete?
See attached notes

Please advise.

Response:

SEE SHEET SS-4 WITH DELTA 1 REVISION
DATED 6/23/2016.

Mark A. Gervasio, P.E.

Answered By


GERVASIO & ASSOC

Company

6/23/2016

Date

CONTRACTOR ALTERNATE

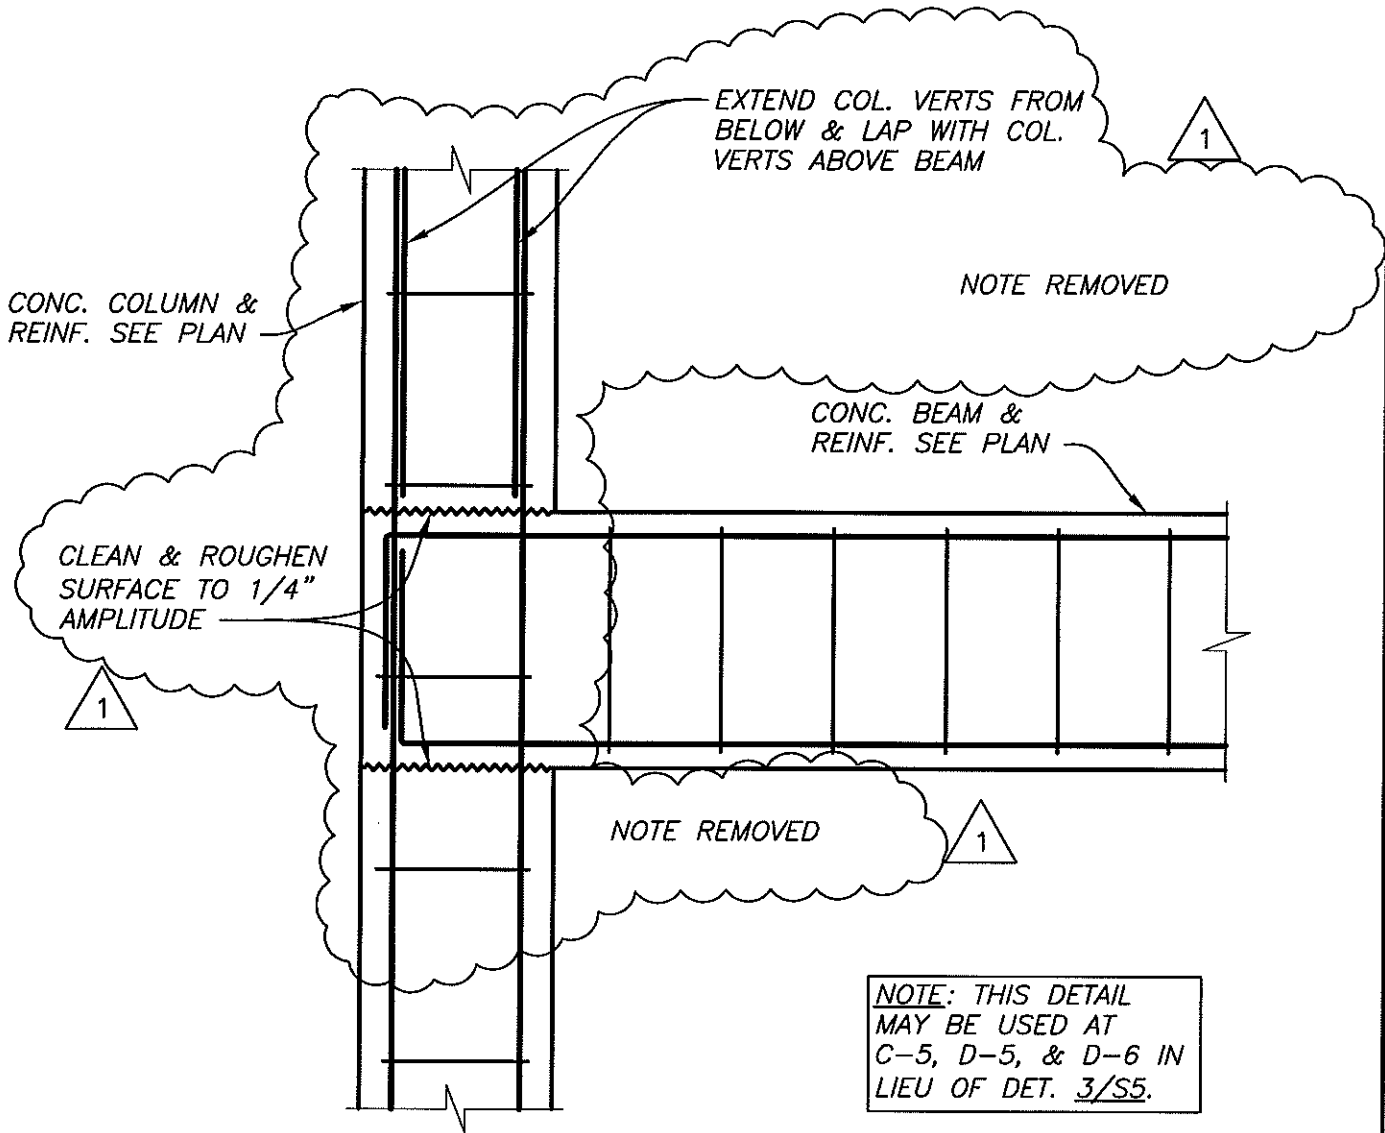

NOTE: THIS DETAIL
 MAY BE USED AT
 C-5, D-5, & D-6 IN
 LIEU OF DET. 3/S5.

3
S5 **ALTERNATE BEAM TO COLUMN CONN.**
(REVISED DETAIL)


1"=1'-0"
 6/23/16

ONLY INFORMATION IN CLOUD HAS BEEN CHANGED.
 SEE CONTRACT DOCUMENTS FOR INFORMATION NOT CALLED OUT.

CONTRACTOR ALTERNATE FOR 2ND FLOOR BEAM TO COLUMN
 CONNECTIONS AT C-5, D-5, & D-6. (REVISED FOR 3 POURS)

GERVASIO & ASSOC. INC.
 CONSULTING ENGINEERS
 77 E. THOMAS ROAD, SUITE 120
 PHOENIX, ARIZONA 85012
 (602) 285-1720 FAX 285-1530

MESA PUBLIC SAFETY TRAINING FACILITY
 BURN FACILITY EXPANSION
 3260 N. 40TH STREET
 MESA, ARIZONA

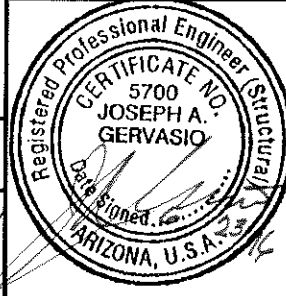

Job No.	4082.1 S02
Date	6/23/16
By	MAS, EMK
Sheet No.	SS-4

This drawing is an instrument of service. It is the property of GERVASIO & ASSOCIATES, INC., and may not be reproduced or reproduction hereof used without permission.

\\GERVASIO3\Drafting\Projects\2014\40820 - Mesa Burn Building\SKETCHES\40820S01SS4.dwg Plotted 6/23/16 by Eric K